

LYNDHURST ROAD SUBDIVISION - STAGE 7

**GREENSTONE LAND
DEVELOPMENT LTD
PROJECT NO. J4963
FOR AS-BUILT**

DRAWING SHEET LIST		
SHEET NO.	SHEET NAME	REV
AB-000	COVER	
AB-001	AS-BUILT CONTOUR PLAN	1
AB-002	ROADING AND ROAD FEATURES AS-BUILT PLAN	1
AB-003	SEWER AS-BUILT PLAN	1
AB-004	STORMWATER AS-BUILT PLAN	1
AB-005	WATER AS-BUILT PLAN	1







NOTES: ALL LOTS ARE FORMED TO A MINIMUM OF RL:19.80

Septic Tank Site
(Removed &
Backfilled 1.5m
Deep)

Ex Bore

KEY:

-  - PRIMARY FLOW PATH
-  - PRIMARY FLOW PATH
-  - MAJOR CONTOURS
-  - MINOR CONTOURS

SAFETY IN DESIGN			
ALL REASONABLY PRACTICABLE STEPS HAVE BEEN TAKEN TO ENSURE SAFETY IN DESIGN HAS BEEN CONSIDERED WITHIN STRATA GROUPS SCOPE OF WORK FOR THIS DESIGN IN ACCORDANCE WITH IPENZ PRACTICE NOTE 07 'DESIGN FOR SAFETY' IN BUILDINGS AND OTHER STRUCTURES (JULY 2006). IT REMAINS THE RESPONSIBILITY OF THE OWNER AND/OR OPERATOR TO ENSURE APPROPRIATE PRACTICES ARE IN PLACE TO PROTECT THE SAFETY OF THE WORKERS AND THE PUBLIC IN THE OPERATION OF THE FACILITY.			
1	FOR AS-BUILT	21/08/2019	MC
REV	REASON FOR ISSUE	DATE	BY

REV	REASON FOR ISSUE	DATE	BY

THE CONTRACTOR IS TO BE AWARE OF ALL INSPECTIONS TO BE MADE BY THE ENGINEER AS A REQUIREMENT OF THE PRODUCER STATEMENT PS4 CONSTRUCTION REVIEW DOCUMENTATION. THE ENGINEER WILL REQUIRE 24 HOURS PRIOR NOTIFICATION WHEN ALL STRUCTURAL ELEMENTS ARE READY TO BE INSPECTED.

stratagroup
CONSULTING ENGINEERS

P 06 876 7646
F 06 876 7645
www.stratagroup.net.nz

PO BOX 758
Business HQ
1/308 Queen Street East
Hastings, New Zealand

Structural Fire Civil Project Management

CLIENT:

Greenstone
LAND DEVELOPMENTS


PROJECT: **LYNDHURST ARBUCKLE SUBDIVISION - STAGE 7**

LYNDHURST ROAD
HASTINGS

TITLE: **AS-BUILT CONTOUR PLAN**

This drawing and its contents are the property of Strata Group Consulting Engineers Ltd. Any unauthorized employment or reproduction in full or part is forbidden.

DESIGNED MC	0 5 10 20 30
DRAWN MC	Full Size 1:500 ; Half Size 1:1000
CHECKED DJ	Scale (m)
DATE 21/8/19	
PROJECT NO.: J4693	SHEET: AB-001 REVISION: 1

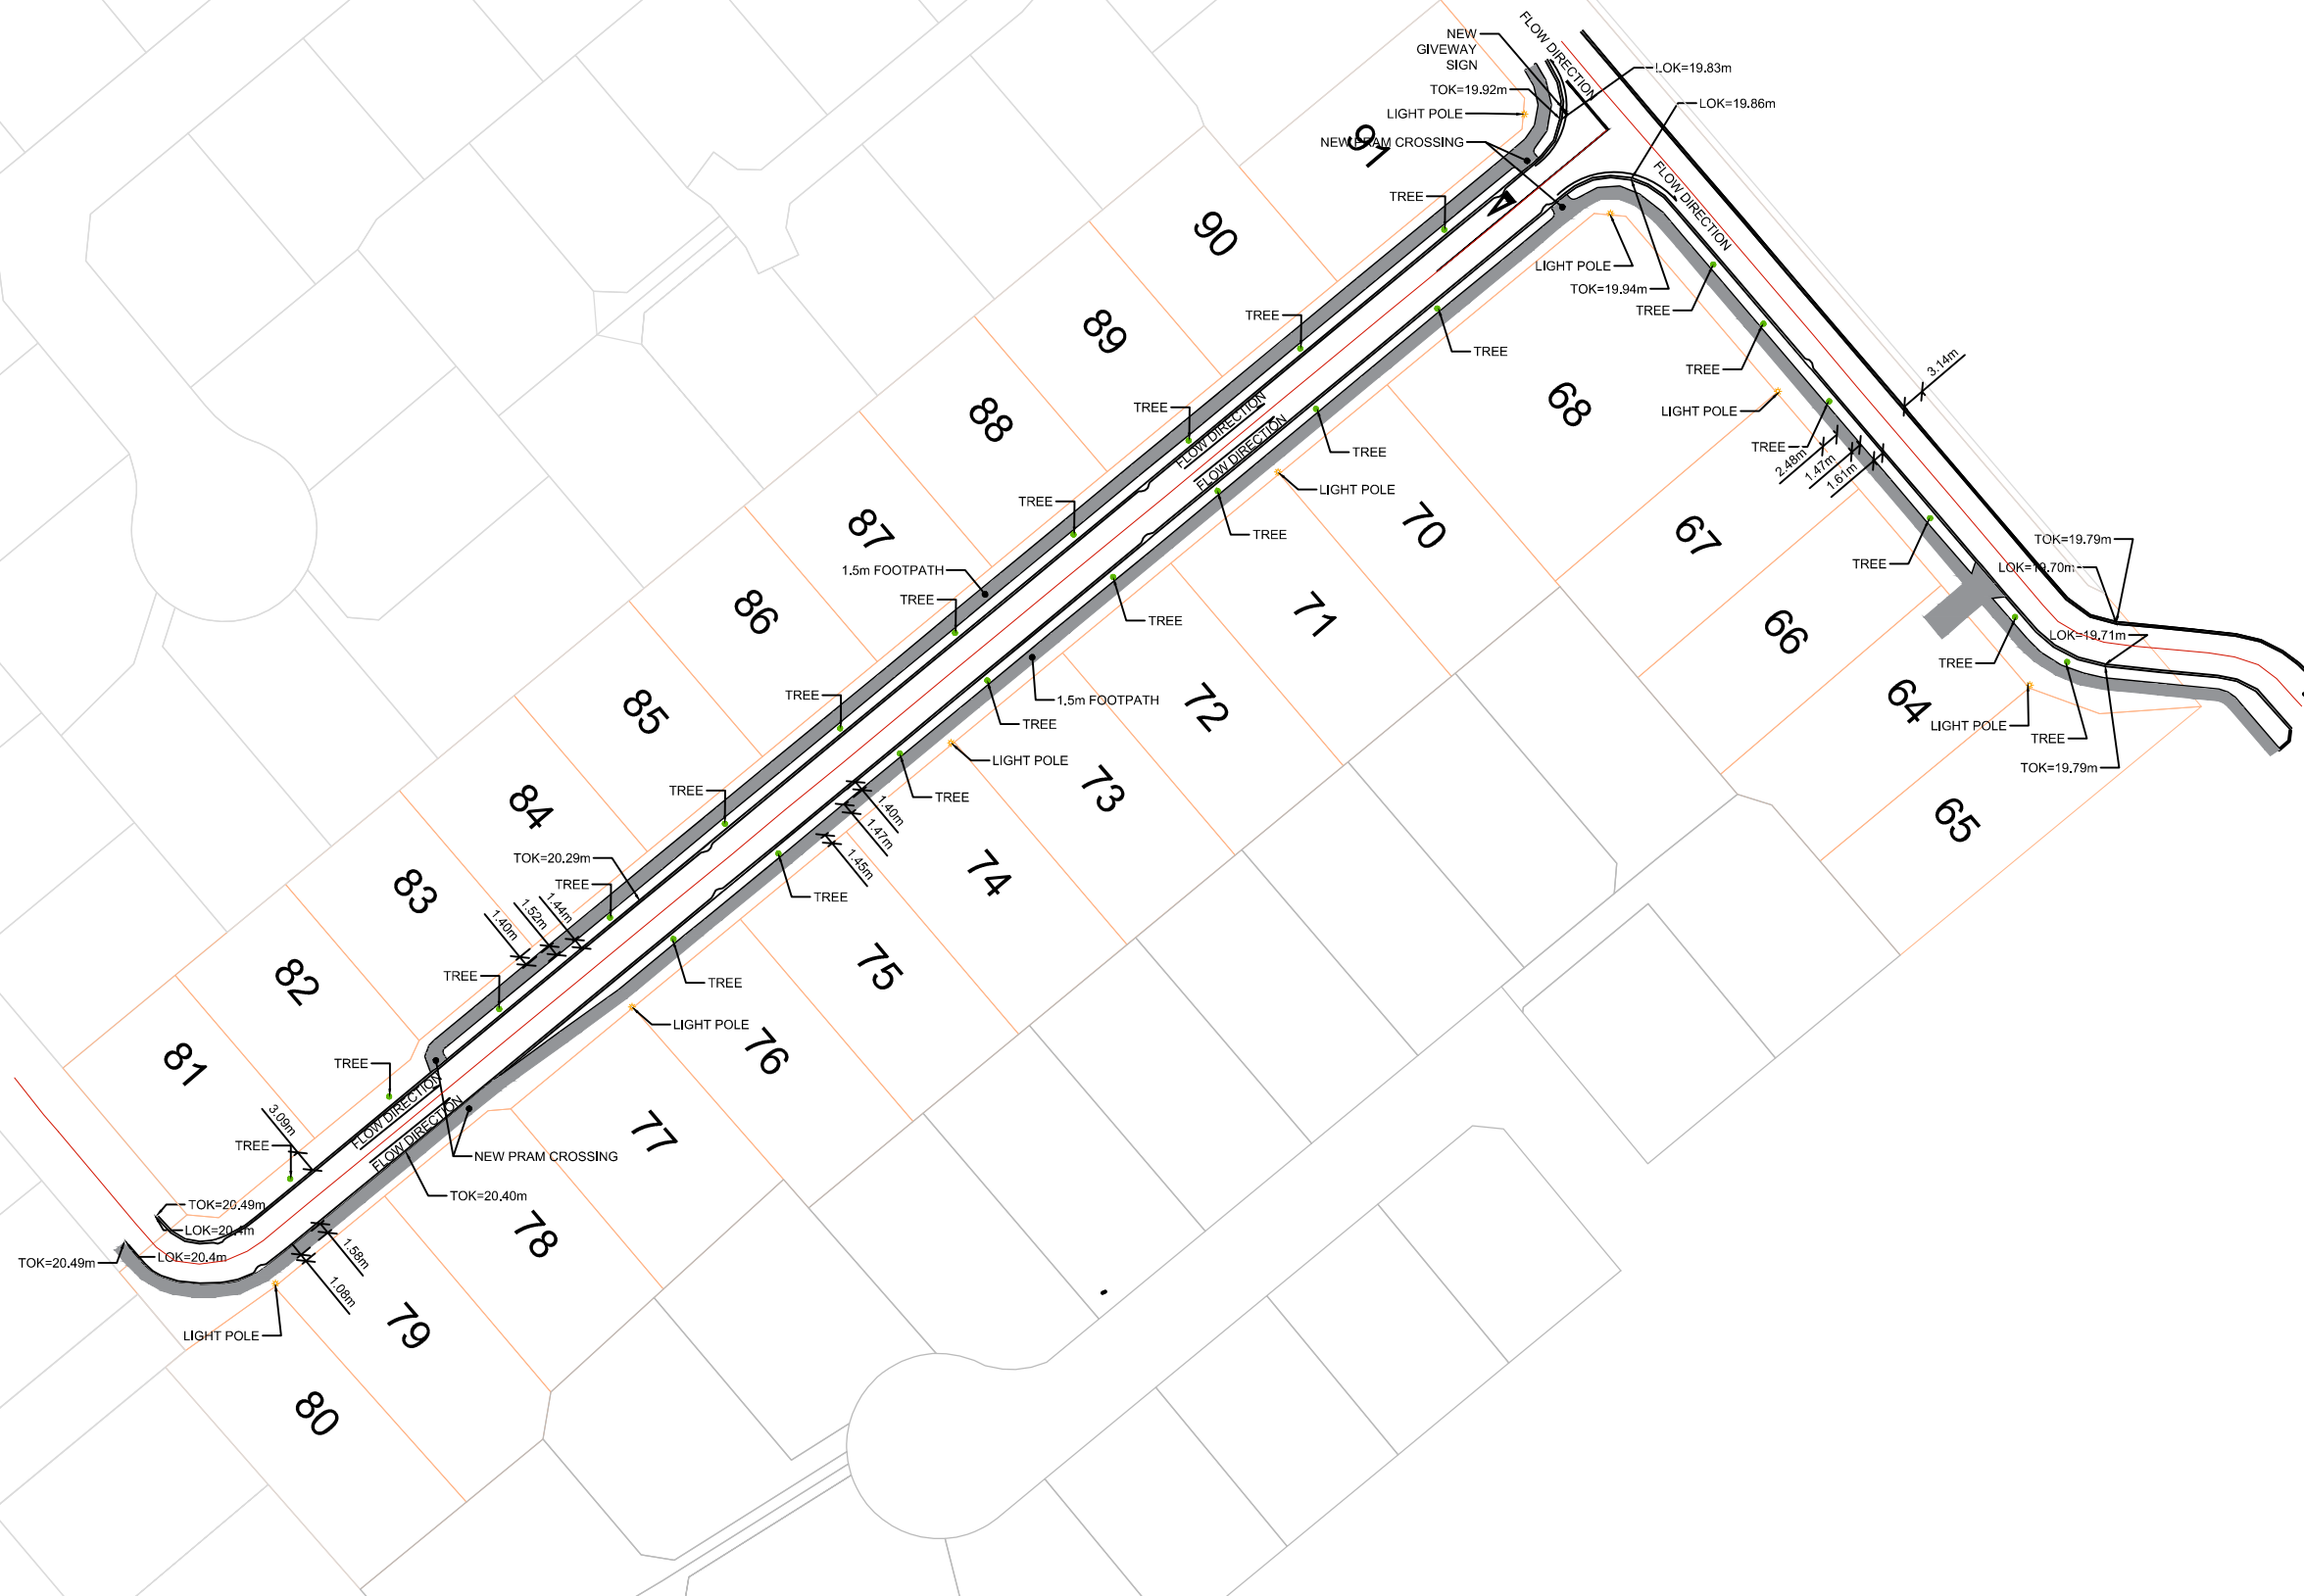

SAFETY IN DESIGN
 ALL REASONABLY PRACTICABLE STEPS HAVE BEEN TAKEN TO ENSURE SAFETY IN DESIGN HAS BEEN CONSIDERED WITHIN STRATA GROUPS SCOPE OF WORK FOR THIS DESIGN IN ACCORDANCE WITH IPENZ PRACTICE NOTE 07 "DESIGN FOR SAFETY IN BUILDINGS AND OTHER STRUCTURES (JULY 2006)". IT REMAINS THE RESPONSIBILITY OF THE OWNER AND/OR OPERATOR TO ENSURE APPROPRIATE PRACTICES ARE IN PLACE TO PROTECT THE SAFETY OF THE WORKERS AND THE PUBLIC IN THE OPERATION OF THE FACILITY.

REV	REASON FOR ISSUE	DATE	BY
1	FOR ASBUILT	21/08/2019	MC

THE CONTRACTOR IS TO BE AWARE OF ALL INSPECTIONS TO BE MADE BY THE ENGINEER AS A REQUIREMENT OF THE PRODUCER STATEMENT PSA CONSTRUCTION REVIEW DOCUMENTATION. THE ENGINEER WILL REQUIRE 24 HOURS PRIOR NOTIFICATION WHEN ALL STRUCTURAL ELEMENTS ARE READY TO BE INSPECTED.

stratagroup
 CONSULTING ENGINEERS
 P 06 876 7646
 F 06 876 7645
 www.stratagroup.net.nz
 PO BOX 758
 Business HQ
 1/308 Queen Street East
 Hastings, New Zealand
 Structural Fire Civil Project Management


CLIENT:

Greenstone
 LAND DEVELOPMENTS

PROJECT:
LYNDHURST ARBUCKLE
SUBDIVISION - STAGE 7
 LYNDHURST ROAD
 HASTINGS

TITLE:
ROADING
ASBULT PLAN
 This drawing and its contents are the property of Strata Group Consulting Engineers Ltd. Any unauthorized employment or reproduction in full or part is forbidden.

DESIGNED DJ	0 5 10 20 30
DRAWN MC	Full Size 1:500 ; Half Size 1:1000
CHECKED DJ	Scale (m)
DATE 16/08/19	
PROJECT NO.: J4693	SHEET: AB-002
	REVISION: 1

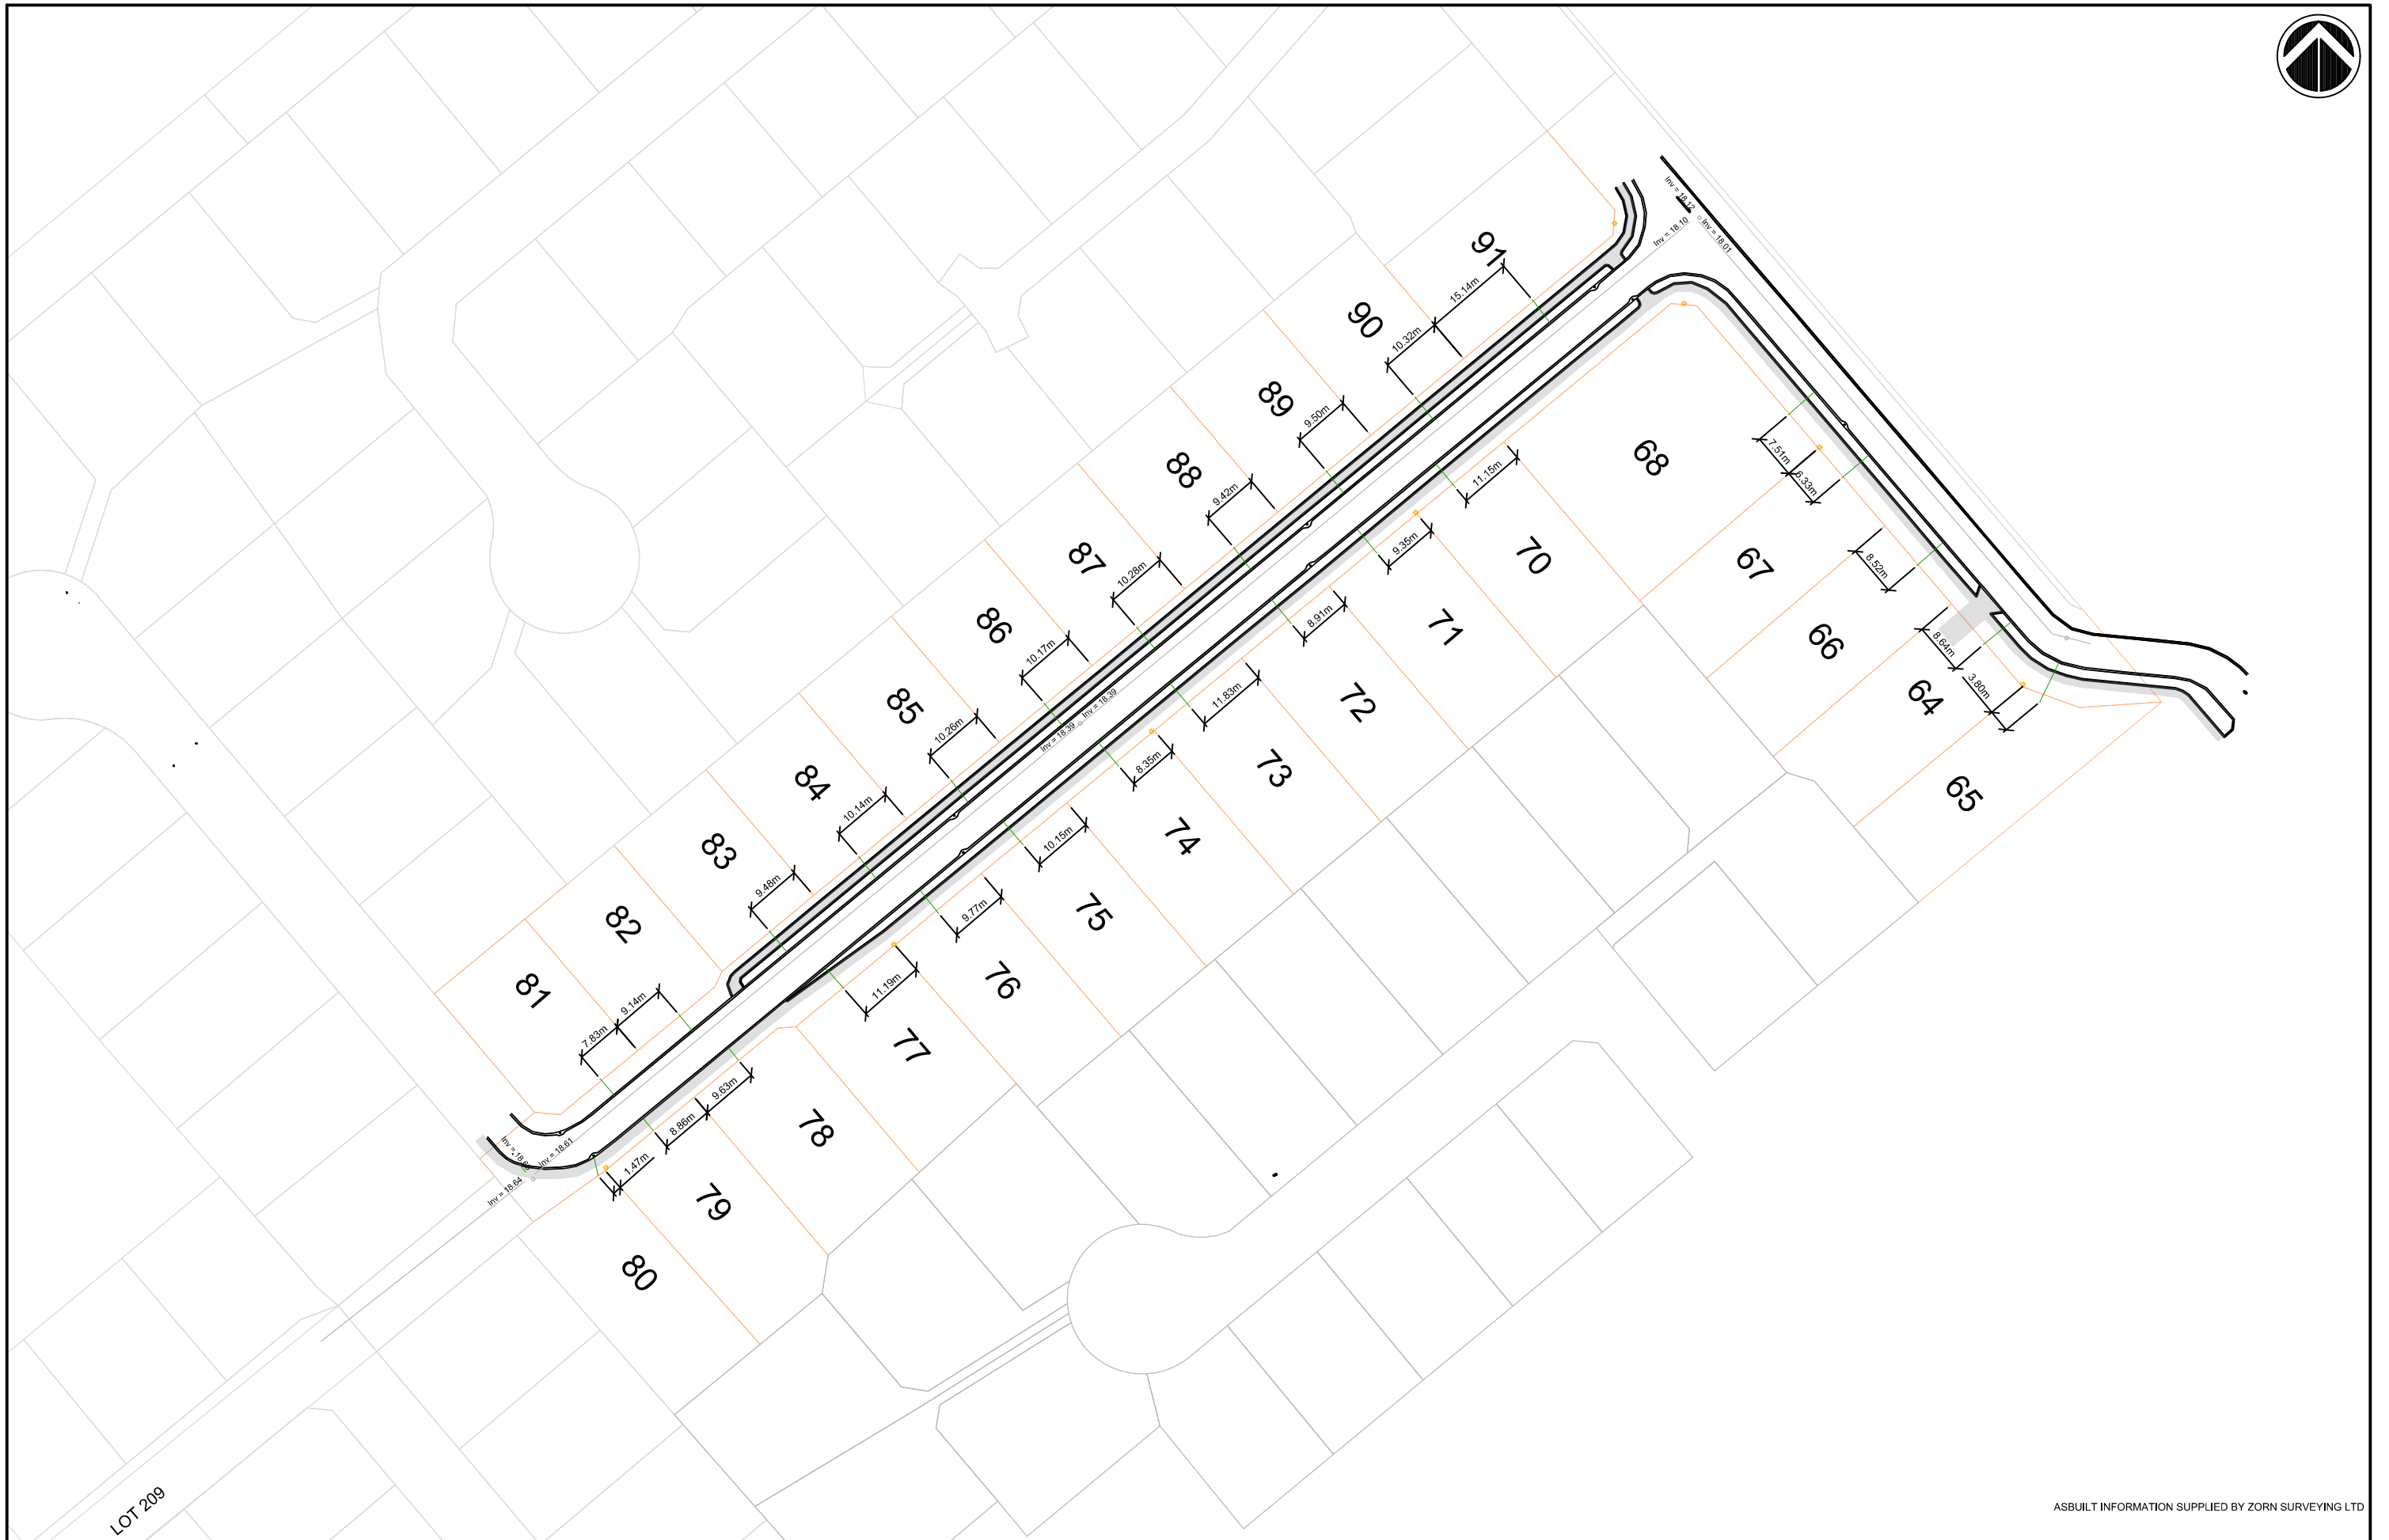

LOT 209

ASBULT INFORMATION SUPPLIED BY ZORN SURVEYING LTD

SAFETY IN DESIGN

ALL REASONABLY PRACTICABLE STEPS HAVE BEEN TAKEN TO ENSURE SAFETY IN DESIGN HAS BEEN CONSIDERED WITHIN STRATA GROUPS SCOPE OF WORK FOR THIS DESIGN IN ACCORDANCE WITH IPENZ PRACTICE NOTE 07 'DESIGN FOR SAFETY IN BUILDINGS AND OTHER STRUCTURES (JULY 2006)'. IT REMAINS THE RESPONSIBILITY OF THE OWNER AND/OR OPERATOR TO ENSURE APPROPRIATE PRACTICES ARE IN PLACE TO PROTECT THE SAFETY OF THE WORKERS AND THE PUBLIC IN THE OPERATION OF THE FACILITY.

REV	REASON FOR ISSUE	DATE	BY
1	FOR ASBULT	21/08/2019	MC

DESIGNED	DRAWN	CHECKED	DATE
DJ	MC	DJ	16/08/19

THE CONTRACTOR IS TO BE AWARE OF ALL INSPECTIONS TO BE MADE BY THE ENGINEER AS A REQUIREMENT OF THE PRODUCER STATEMENT PS4 CONSTRUCTION REVIEW DOCUMENTATION. THE ENGINEER WILL REQUIRE 24 HOURS PRIOR NOTIFICATION WHEN ALL STRUCTURAL ELEMENTS ARE READY TO BE INSPECTED.

stratagroup
CONSULTING ENGINEERS

P 06 876 7646
F 06 876 7645
www.stratagroup.net.nz

PO BOX 758
Business HQ
1/308 Queen Street East
Hastings, New Zealand

Structural Fire Civil Project Management

CLIENT:


Greenstone
LAND DEVELOPMENTS

PROJECT: **LYNDHURST ARBUCKLE SUBDIVISION - STAGE 7**
LYNDHURST ROAD
HASTINGS

TITLE: **STORMWATER ASBULT PLAN**

This drawing and its contents are the property of Strata Group Consulting Engineers Ltd. Any unauthorized employment or reproduction in full or part is forbidden.

DESIGNED DJ	0	5	10	20	30
DRAWN MC	Full Size 1:500 ; Half Size 1:1000				
CHECKED DJ	Scale (m)				
DATE 16/08/19	PROJECT NO. J4693	SHEET AB-003	REVISION: 1		

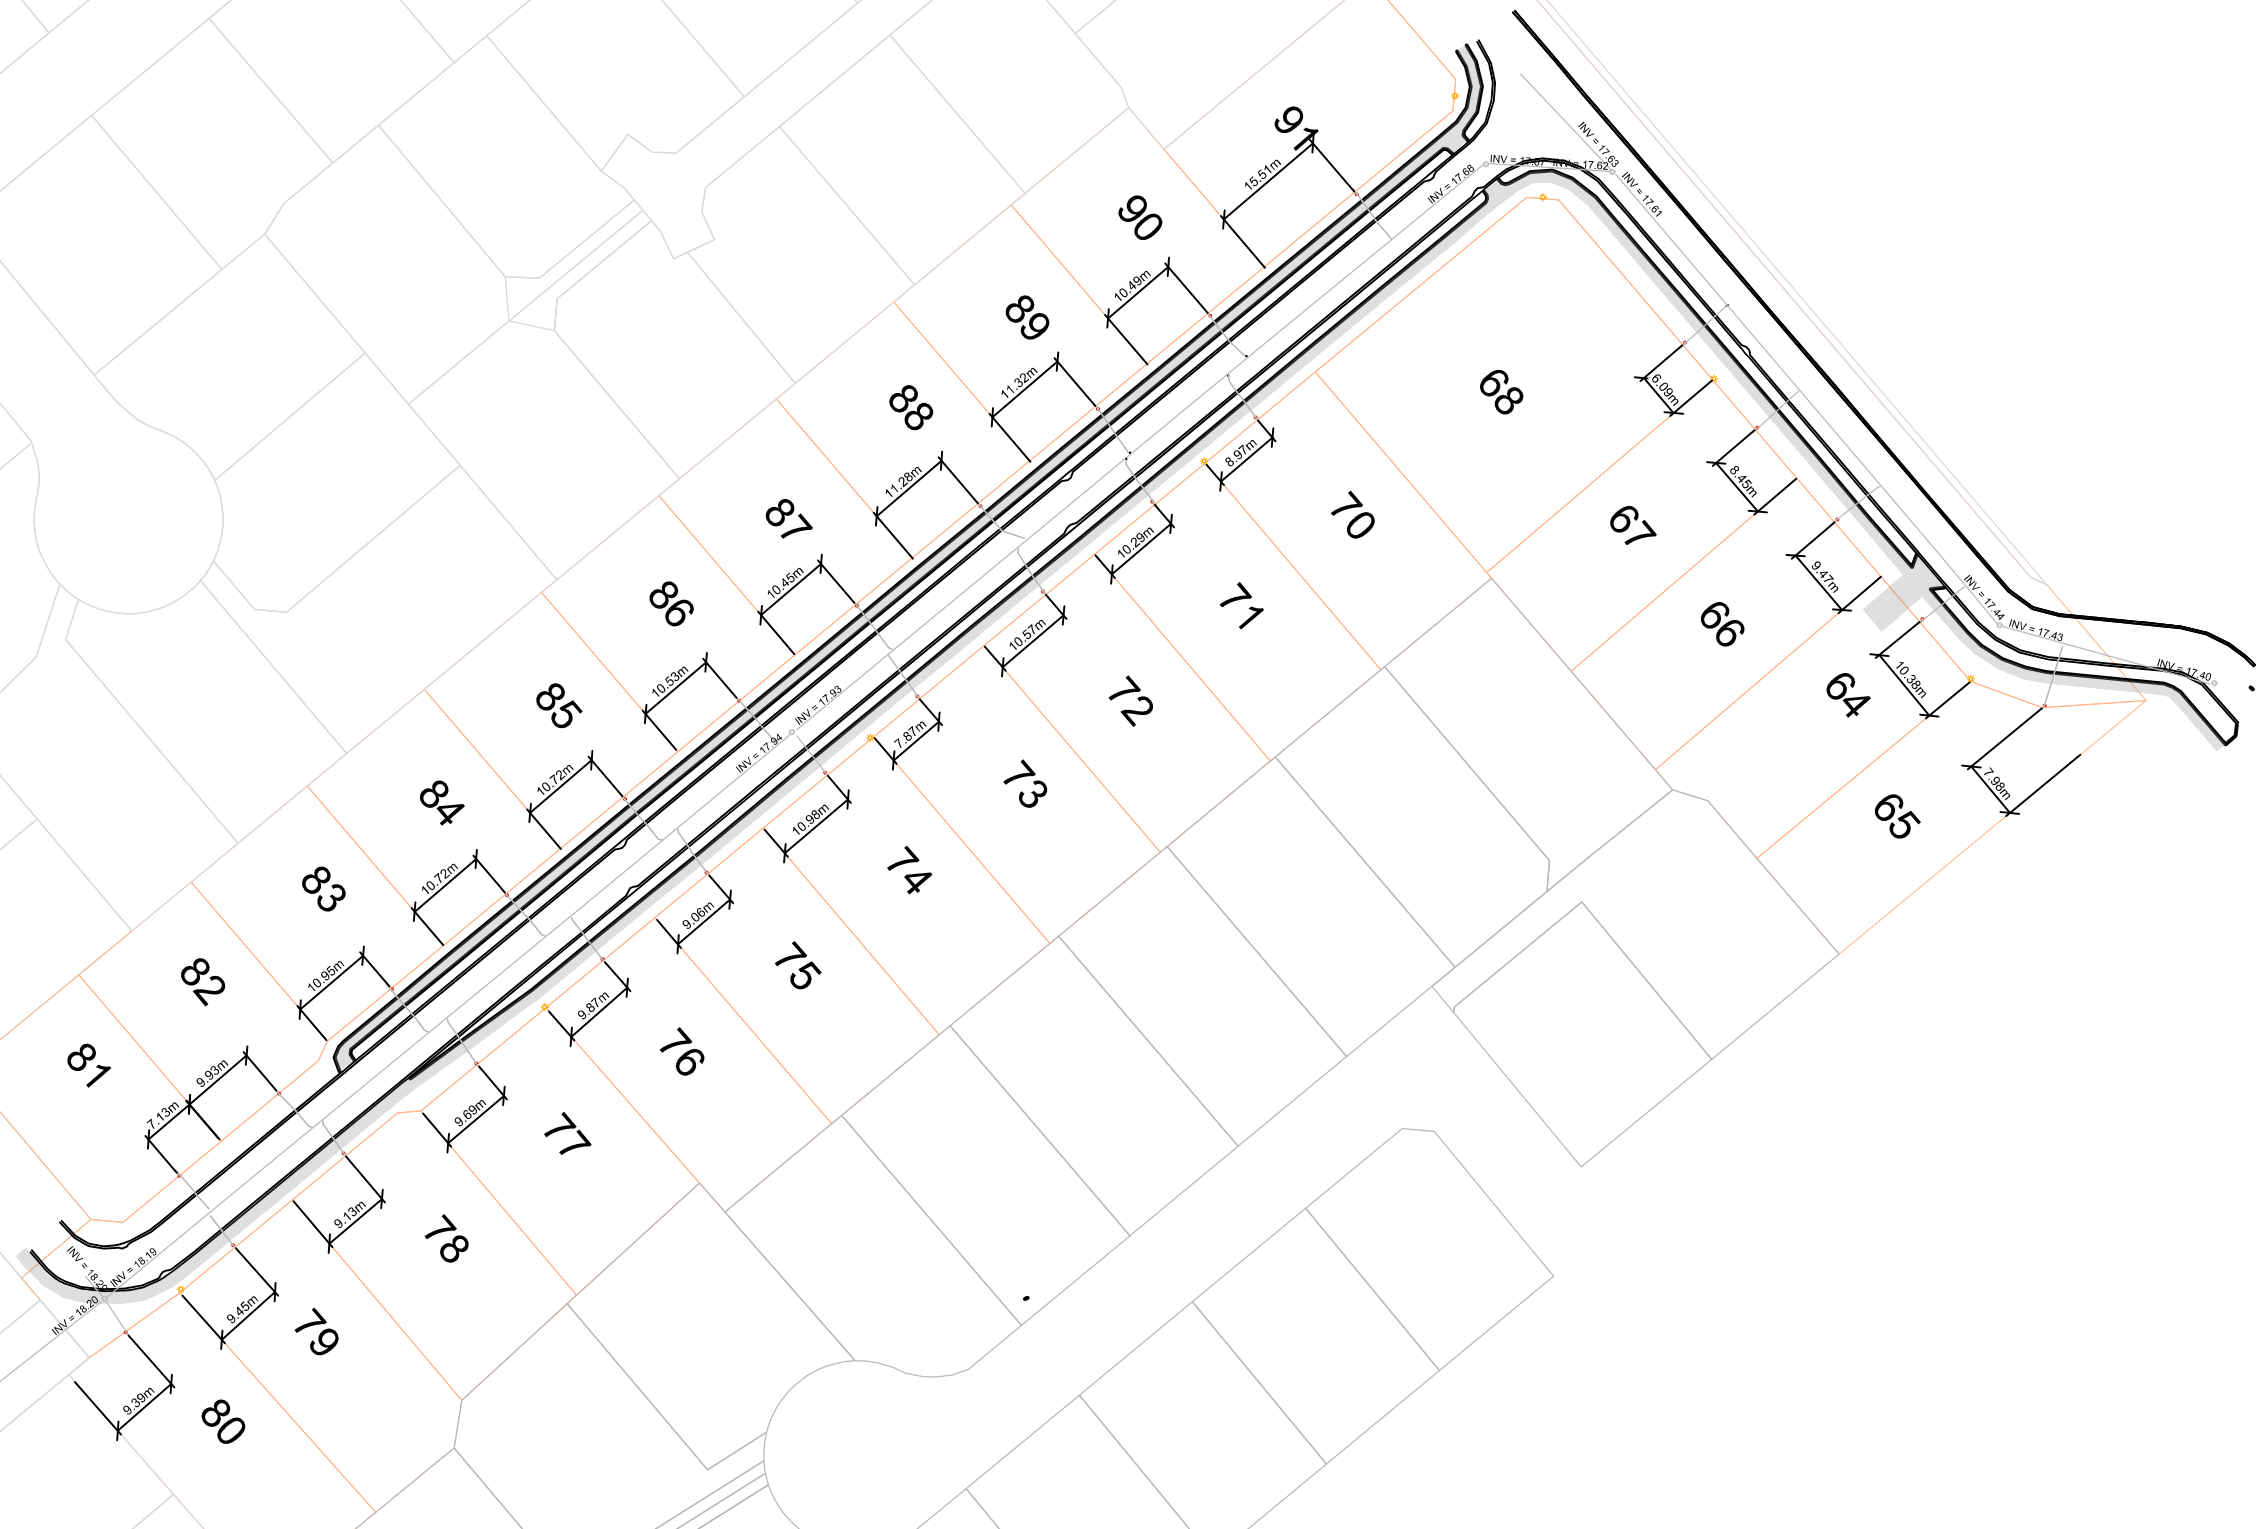

ASBULT INFORMATION SUPPLIED BY ZORN SURVEYING LTD

SAFETY IN DESIGN
 ALL REASONABLY PRACTICABLE STEPS HAVE BEEN TAKEN TO ENSURE SAFETY IN DESIGN HAS BEEN CONSIDERED WITHIN STRATA GROUPS SCOPE OF WORK FOR THIS DESIGN IN ACCORDANCE WITH IPENZ PRACTICE NOTE 07 "DESIGN FOR SAFETY IN BUILDINGS AND OTHER STRUCTURES (JULY 2006)". IT REMAINS THE RESPONSIBILITY OF THE OWNER AND/OR OPERATOR TO ENSURE APPROPRIATE PRACTICES ARE IN PLACE TO PROTECT THE SAFETY OF THE WORKERS AND THE PUBLIC IN THE OPERATION OF THE FACILITY.

REV	REASON FOR ISSUE	DATE	BY
1	FOR ASBULT	21/08/2019	MC

THE CONTRACTOR IS TO BE AWARE OF ALL INSPECTIONS TO BE MADE BY THE ENGINEER AS A REQUIREMENT OF THE PRODUCER STATEMENT PS4 CONSTRUCTION REVIEW DOCUMENTATION. THE ENGINEER WILL REQUIRE 24 HOURS PRIOR NOTIFICATION WHEN ALL STRUCTURAL ELEMENTS ARE READY TO BE INSPECTED.

stratagroup
 CONSULTING ENGINEERS
 P 06 876 7646
 F 06 876 7645
 www.stratagroup.net.nz
 PO BOX 758
 Business HQ
 1/308 Queen Street East
 Hastings, New Zealand
 Structural Fire Civil Project Management



CLIENT:

Greenstone
 LAND DEVELOPMENTS

PROJECT:
**LYNDHURST ARBUCKLE
 SUBDIVISION - STAGE 7**
 LYNDHURST ROAD
 HASTINGS

TITLE:
**SEWER
 ASBULT PLAN**
 This drawing and its contents are the property of Strata Group Consulting Engineers Ltd. Any unauthorized employment or reproduction in full or part is forbidden.

DESIGNED DJ	0 5 10 20 30
DRAWN MC	Full Size 1:500 ; Half Size 1:1000
CHECKED DJ	Scale (m)
DATE 16/08/19	
PROJECT NO. J4693	SHEET AB-004
	REVISION: 1

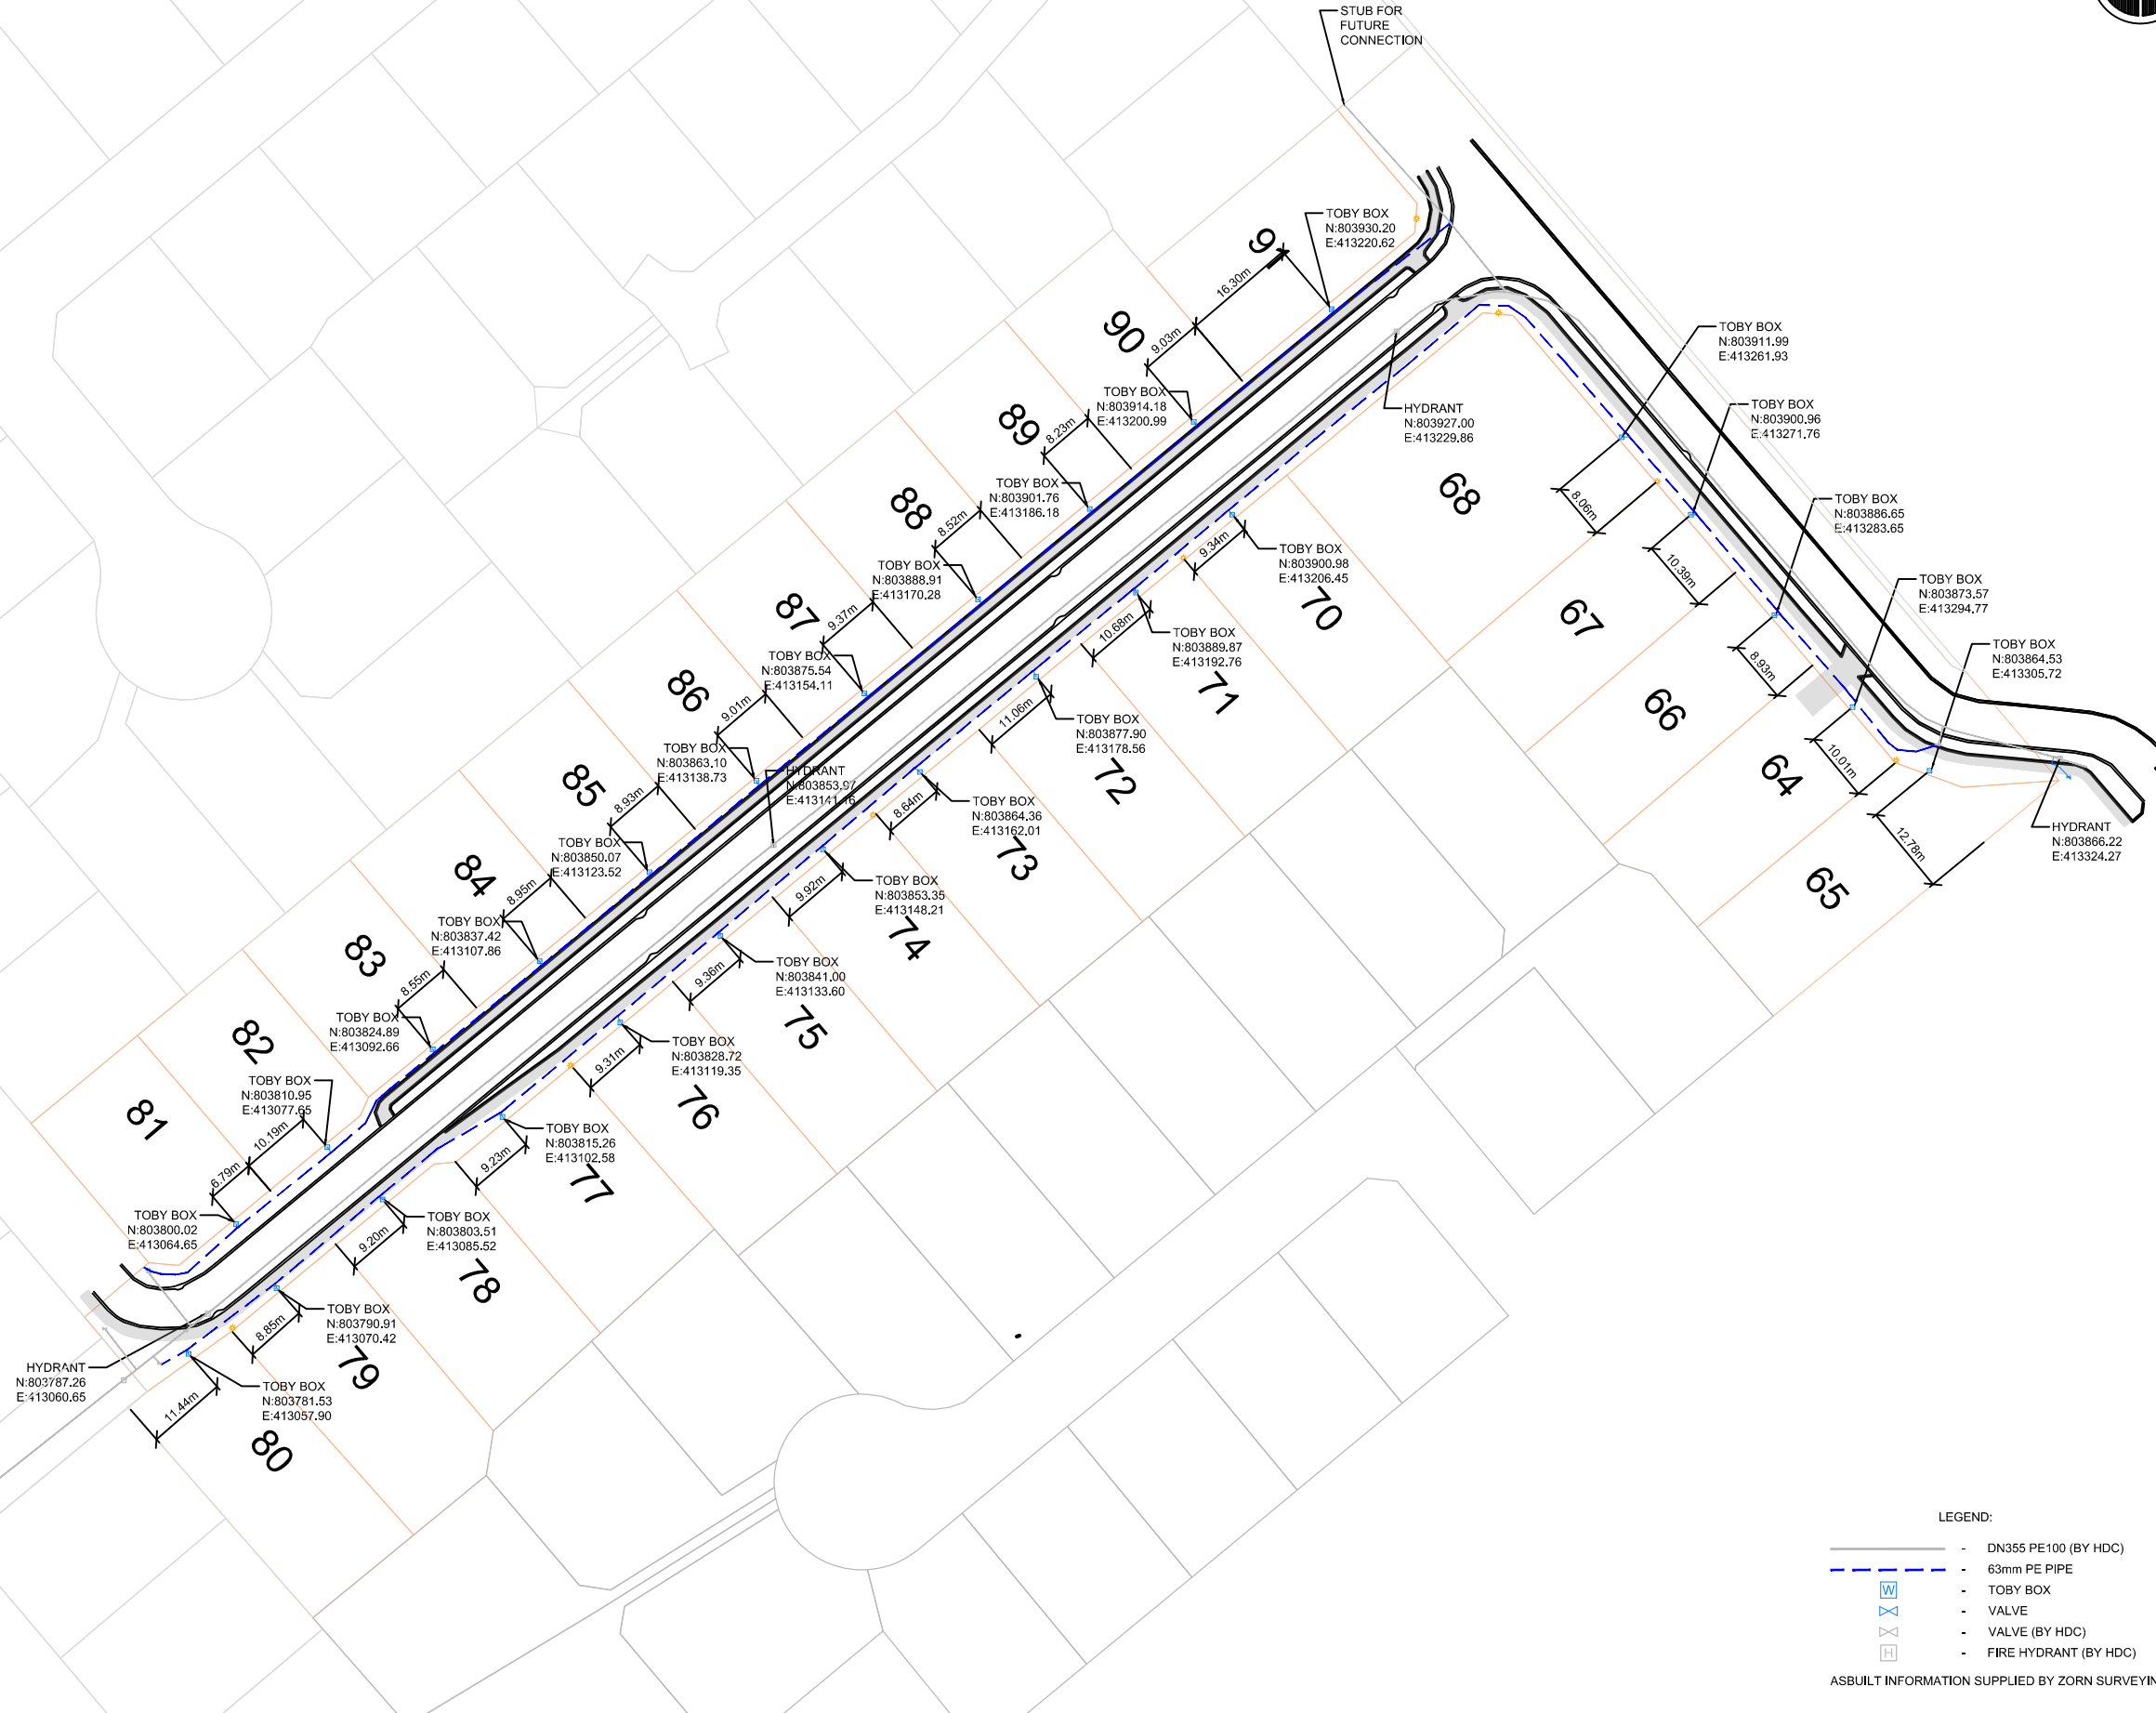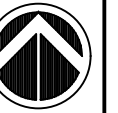

LEGEND:

- DN355 PE100 (BY HDC)
- 63mm PE PIPE
- TOBY BOX
- VALVE
- VALVE (BY HDC)
- FIRE HYDRANT (BY HDC)

ASBUILT INFORMATION SUPPLIED BY ZORN SURVEYING LTD

SAFETY IN DESIGN
 ALL REASONABLY PRACTICABLE STEPS HAVE BEEN TAKEN TO ENSURE SAFETY IN DESIGN HAS BEEN CONSIDERED WITHIN STRATA GROUPS SCOPE OF WORK FOR THIS DESIGN IN ACCORDANCE WITH IPENZ PRACTICE NOTE 07 "DESIGN FOR SAFETY IN BUILDINGS AND OTHER STRUCTURES (JULY 2006)". IT REMAINS THE RESPONSIBILITY OF THE OWNER AND/OR OPERATOR TO ENSURE APPROPRIATE PRACTICES ARE IN PLACE TO PROTECT THE SAFETY OF THE WORKERS AND THE PUBLIC IN THE OPERATION OF THE FACILITY.

REV	REASON FOR ISSUE	DATE	BY
1	FOR ASBUILT	21/08/2019	MC

THE CONTRACTOR IS TO BE AWARE OF ALL INSPECTIONS TO BE MADE BY THE ENGINEER AS A REQUIREMENT OF THE PRODUCER STATEMENT PSA CONSTRUCTION REVIEW DOCUMENTATION. THE ENGINEER WILL REQUIRE 24 HOURS PRIOR NOTIFICATION WHEN ALL STRUCTURAL ELEMENTS ARE READY TO BE INSPECTED.

stratagroup
 CONSULTING ENGINEERS
 P 06 876 7646
 F 06 876 7645
 www.stratagroup.net.nz
 PO BOX 758
 Business HQ
 1/308 Queen Street East
 Hastings, New Zealand
 Structural Fire Civil Project Management

CLIENT:

Greenstone
 LAND DEVELOPMENTS

PROJECT:
LYNDHURST ARBUCKLE
SUBDIVISION - STAGE 7
 LYNDHURST ROAD
 HASTINGS

TITLE:
WATER
ASBUILT PLAN
 This drawing and its contents are the property of Strata Group Consulting Engineers Ltd. Any unauthorized employment or reproduction in full or part is forbidden.

DESIGNED DJ	0	5	10	20	30
DRAWN MC	Full Size 1:500 ; Half Size 1:1000				
CHECKED DJ	Scale (m)				
DATE 16/08/19	PROJECT NO.:	SHEET:	REVISION:		
	J4693	AB-005	1		